

CALDERDALE METROPOLITAN BOROUGH COUNCIL**WILDLIFE AND COUNTRYSIDE ACT 1981**

10 MAY 2009

**The Wildlife and Countryside (Definitive Maps and Statements)
Regulations 1993 Schedule 7**

APPLICATION FOR MODIFICATION ORDER

DEFINITIVE MAP AND STATEMENT FOR CALDERDALE

To: CALDERDALE METROPOLITAN BOROUGH COUNCIL,
Of: NORTHGATE HOUSE, NORTHGATE, HALIFAX, HX1 1UN

We (i) Mrs J. M. CRAVEN
of (ii) 39, ROBIN HOOD WAY, CLIFTON, BRIGHOUSE HD6 4LA.

hereby apply for an order under Section 53(2) of the Wildlife and Countryside Act 1981
modifying the Definitive Map and Statement of the Area by:

1. Deleting the footpath / bridleway / byway open to all traffic *

shown as number

from

to

2. Adding the footpath ~~bridleway~~ / ~~byway open to all traffic~~ *

from DOLES LANE

to FOOTPATH BRIGHOUSE 83

3. Upgrading / Downgrading * to a footpath / bridleway / byway open to all traffic * the
footpath / bridleway / byway open to all traffic *

shown as number

from

to

4. Varying / Adding to * the particulars relating to the footpath / bridleway / byway open to all traffic *

shown as number

from

to

by providing that

.....

and shown on the map annexed hereto

I/We attach a map and copies of the following documentary evidence (including statements of witnesses) in support of this application:

List of Documents provided (iii):

- A) 8 N^e Witness statements on signed/dated forms v2.1
- B) Photographs taken at each end of route & of in-route foot bridge.
- C) Maps of route

Signed

Date 8/5/06


- (i) Insert name of applicant(s)
(ii) Insert address of applicant(s)

- (iii) Insert list of documents
* Please delete as appropriate

Doles Lane to Footpath Brighthouse 83

Please indicate on this map the route(s) you used.

Mark the locations of any obstructions, stiles, gates, signs or notices.

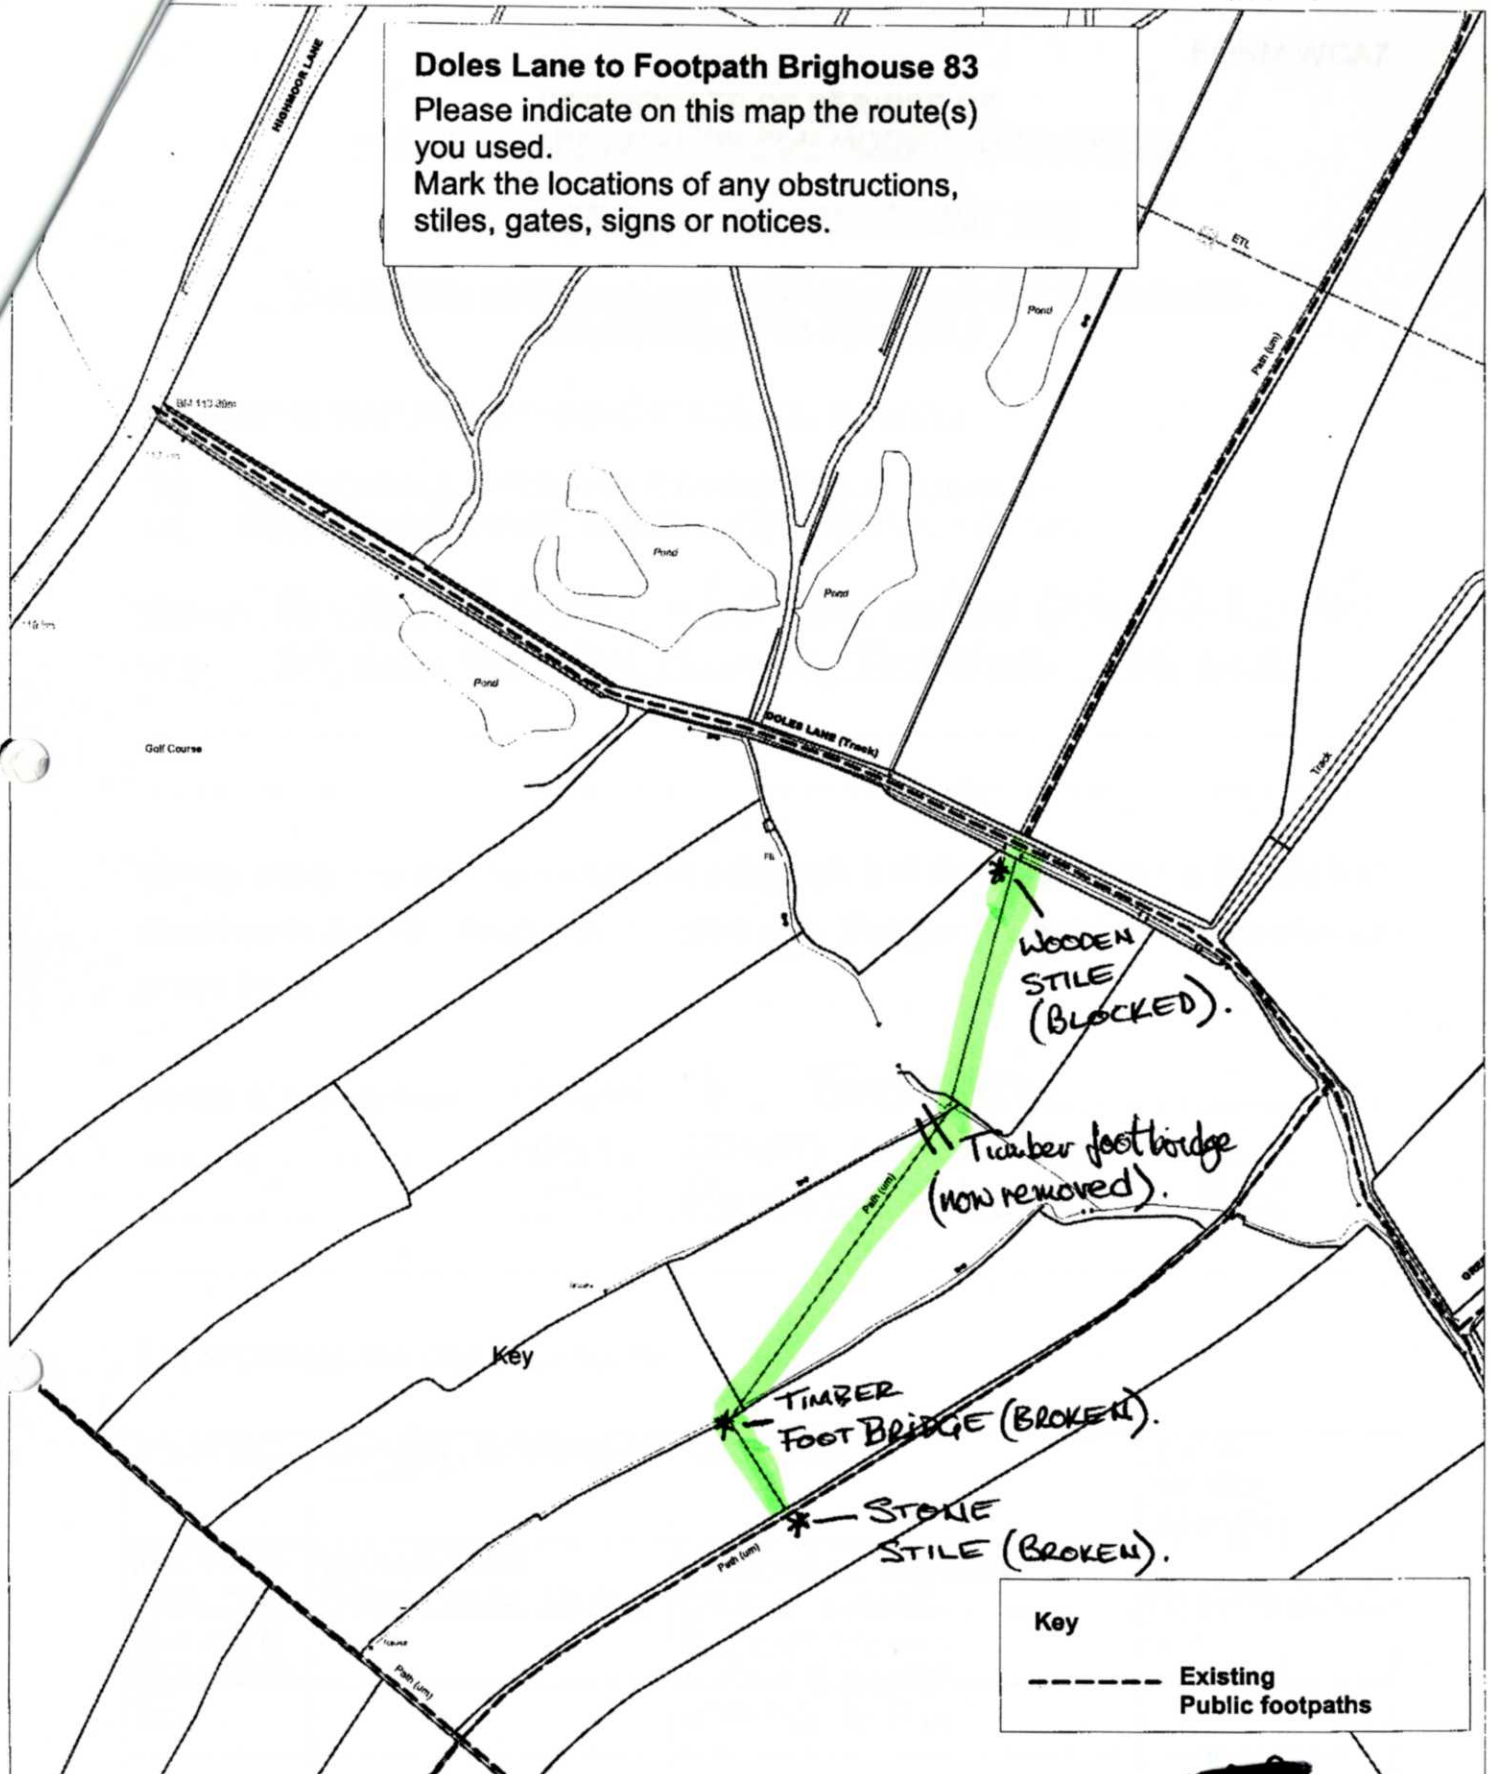

Calderdale
Council

Northgate House, Northgate, HALIFAX,
West Yorkshire, HX1 1UN.

Telephone No. : (01422) 357257

Signed

Date

Scale
1:6000

Drawn By:
PC

Date:
20/12/2005

REGENERATION

ENGINEER

"This copy has been made by or with the authority of Calderdale MBC pursuant to section 47 of the Copyright, Designs and Patents Act 1988 ("the Act"). Unless the Act provides a relevant exception to copyright, the copy must not be copied without the prior permission of the copyright owner."

**CERTIFICATE OF SERVICE OF
NOTICE OF APPLICATION FOR MODIFICATION ORDER**

WILDLIFE AND COUNTRYSIDE ACT 1981

**The Wildlife and Countryside (Definitive Maps and Statements)
Regulations 1993 Schedule 9**

DEFINITIVE MAP AND STATEMENT FOR CALDERDALE

To: CALDERDALE METROPOLITAN BOROUGH COUNCIL,
Of: NORTHGATE HOUSE, NORTHGATE, HALIFAX, HX1 1UN

Have (i) Mr & Mrs J. M. Craven + 6NE (see enclosed forms v2.1 - 8th)
of (ii) 39, ROBIN HOOD WAY, CHIFTON, BRIGHOUSE HD6 4LA

hereby certify that the requirements of paragraph 2 of Schedule 14 to the Wildlife and Countryside Act 1981 have been complied with. (Paragraph 2 is printed on the reverse of this form).

Details of Modification ADDING THE FOOTPATH
FROM: DOLES LANE
TO: FOOTPATH BRIGHOUSE 83

List of Owners and Occupiers Notified:

PLOT NO.	OWNER / OCCUPIER	ADDRESS	DATE NOTICE SERVED
FROM DOLES LANE TO	NEWSMITHS STAINLESS LTD.	FOUNTAIN WORKS CHILD LANE	08/05/06
FOOTPATH BRIGHOUSE 83.		ROBERTTOWN LIVERSEDGE WF15 7 PH.	

Signed 

Date 08/05/06

(i) Insert name of applicant(s) (ii) Insert address of applicant(s)