

CALDERDALE METROPOLITAN BOROUGH COUNCIL**WILDLIFE AND COUNTRYSIDE ACT 1981****The Wildlife and Countryside (Definitive Maps and Statements)
Regulations 1993 Schedule 7****APPLICATION FOR MODIFICATION ORDER**

DEFINITIVE MAP AND STATEMENT FOR CALDERDALE

To: CALDERDALE METROPOLITAN BOROUGH COUNCIL,
Of: NORTHGATE HOUSE, NORTHGATE, HALIFAX, HX1 1UN

I/We (i) **DAVID GROVES**
of (ii) **2 BANKSIDE**
..... **HIDDEN BRIDGE**
..... **Hx7 8EX**

hereby apply for an order under Section 53(2) of the Wildlife and Countryside Act 1981
modifying the Definitive Map and Statement of the Area by:

1. Deleting the footpath / bridleway / restricted byway / byway open to all traffic *
shown as number
from
to
2. Adding the footpath / ~~bridleway~~ / ~~restricted byway~~ / ~~byway open to all traffic~~
from **BANKSIDE**
to **ST. JOHN'S CLOSE**
3. Upgrading / Downgrading * to a footpath / bridleway / restricted byway / byway
open to all traffic *
the footpath / bridleway / restricted byway / byway open to all traffic *
shown as number

from

to

4. Varying / Adding to * the particulars relating to the footpath / bridleway / restricted byway / byway open to all traffic *

shown as number ~~105~~

from ~~5000/105~~

to ~~ST JOHN'S CHURCH~~

by providing that

.....

and shown on the map annexed hereto

I/We attach a map and copies of the following documentary evidence (including statements of witnesses) in support of this application:

List of Documents provided (iii):

..... ~~Handwritten statement from [redacted] (30/7/10)~~

.....

.....

Signed ~~[redacted]~~

Date ~~2/8/10~~


- (i) Insert name of applicant(s)
(ii) Insert address of applicant(s)

- (iii) Insert list of documents
* Please delete as appropriate

CLAIMED PUBLIC RIGHT OF WAY

**PLEASE INDICATE ON THIS MAP THE ROUTE
YOU HAVE USED**

**MARK THE LOCATIONS OF ANY OBSTRUCTIONS,
STILES, GATES, SIGNS OR NOTICES
PLEASE SIGN AND DATE THIS PLAN**

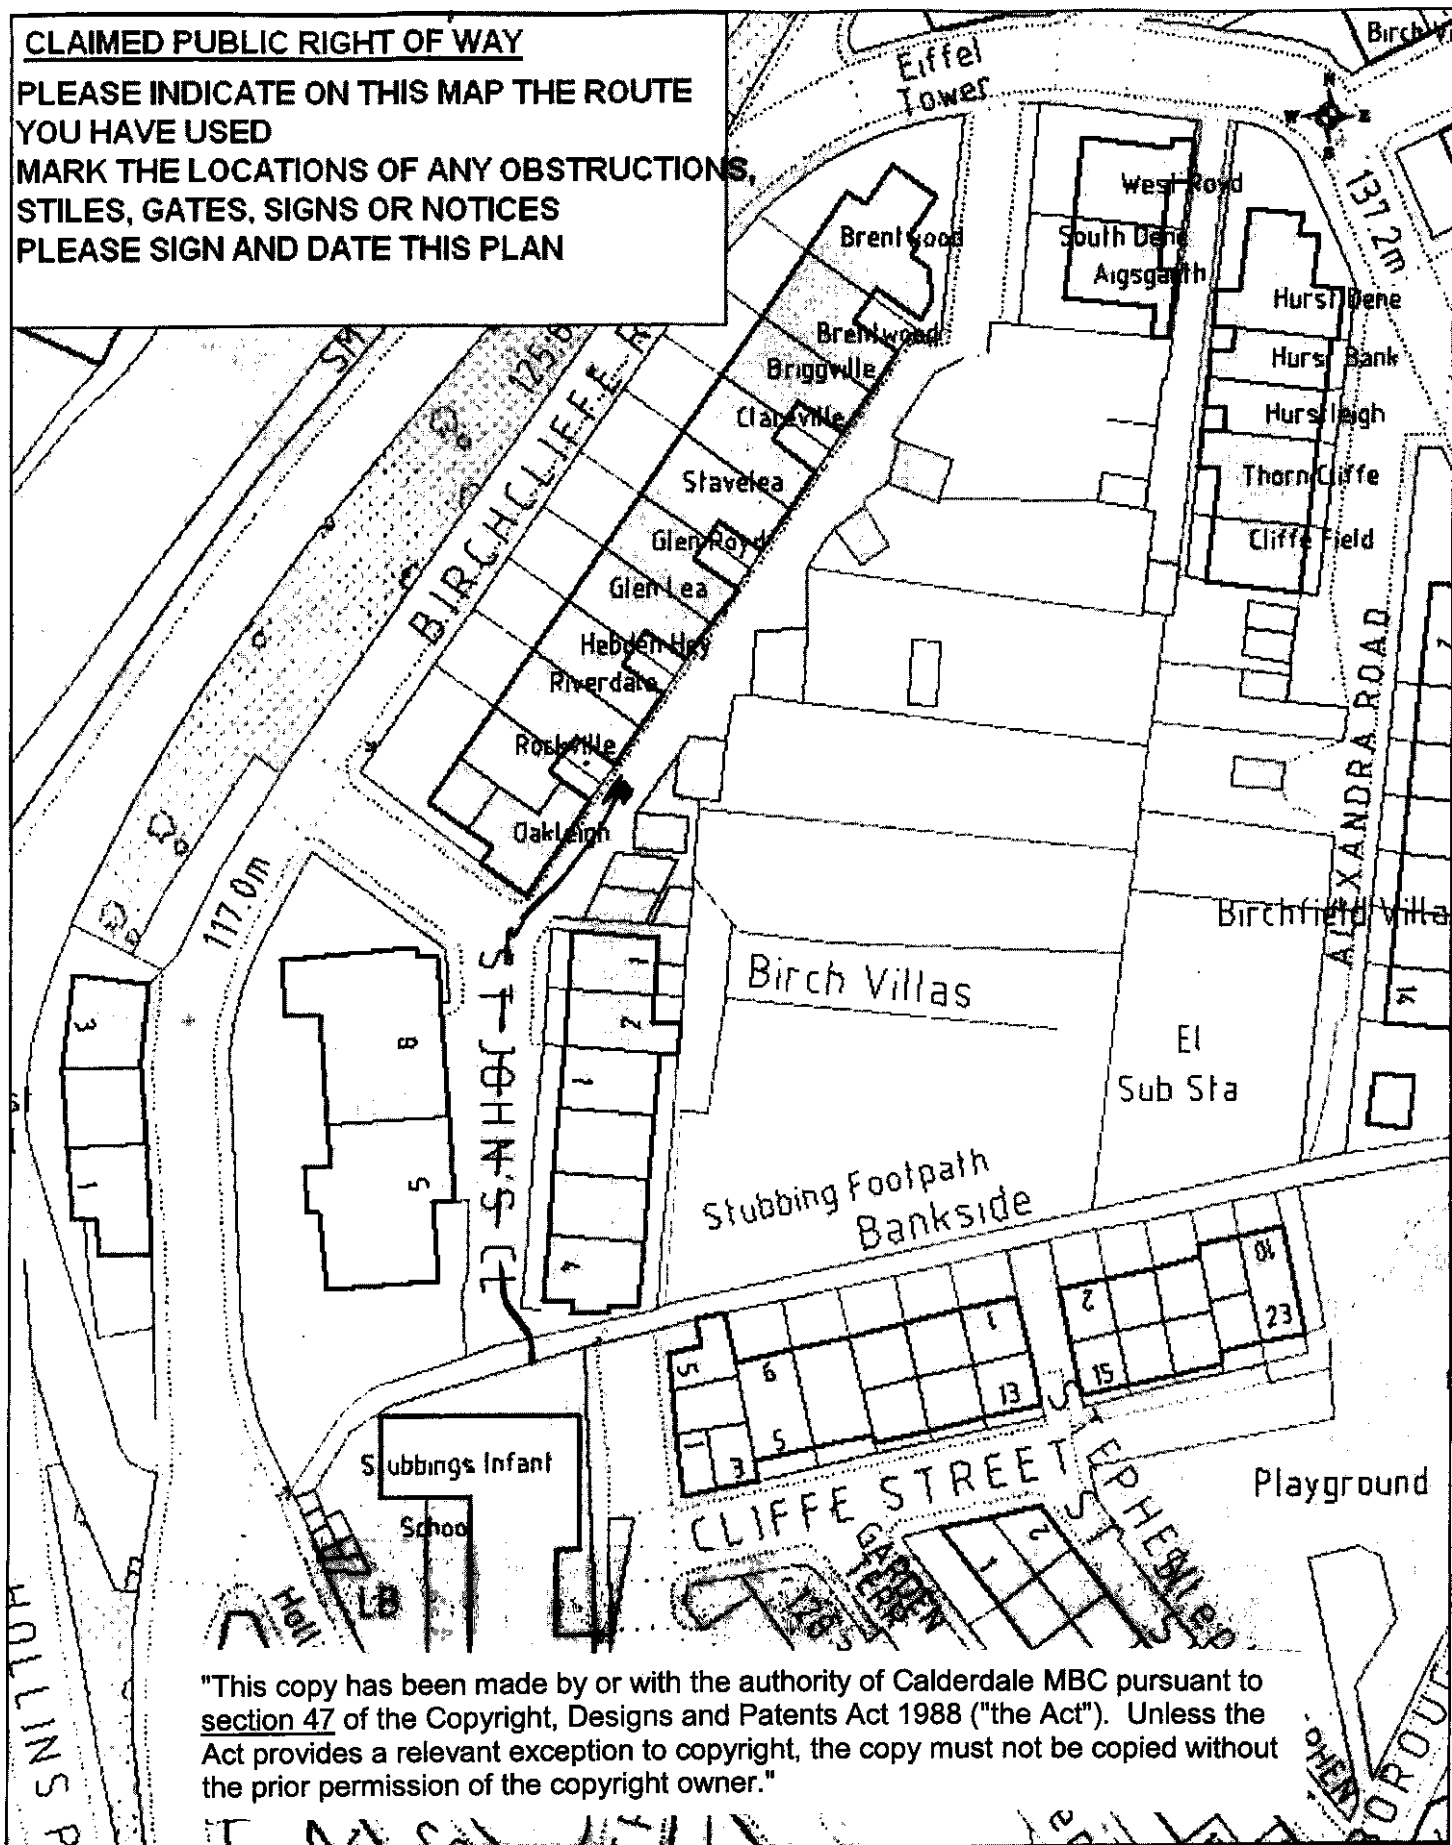

"This copy has been made by or with the authority of Calderdale MBC pursuant to section 47 of the Copyright, Designs and Patents Act 1988 ("the Act"). Unless the Act provides a relevant exception to copyright, the copy must not be copied without the prior permission of the copyright owner."

Calderdale
Council

**Economy & Environment
HIGHWAYS & ENGINEERING**

Northgate House, Northgate, HALIFAX,
West Yorkshire, HX1 1UN.

Telephone No. : (01422) 357257
Fax No. : (01422) 392193

Website: www.calderdale.gov.uk

Email: highwaysandengineering@calderdale.gov.uk

Signed

Date

11/8/10

Scale
1: 750

Drawn By:
ITurner

Date:
30/07/2010

© Crown copyright. All rights reserved
(Calderdale MBC) (100020089) (2008)

02 SEP 2010

**CERTIFICATE OF SERVICE OF
NOTICE OF APPLICATION FOR MODIFICATION ORDER**

WILDLIFE AND COUNTRYSIDE ACT 1981

**The Wildlife and Countryside (Definitive Maps and Statements)
Regulations 1993 Schedule 9**

DEFINITIVE MAP AND STATEMENT FOR CALDERDALE

To: CALDERDALE METROPOLITAN BOROUGH COUNCIL,
Of: NORTHGATE HOUSE, NORTHGATE, HALIFAX, HX1 1UN

I/we (i) DAVID GROVES
of (ii) 2 BANKSIDE
HEBURN BRIDGE

hereby certify that the requirements of paragraph 2 of Schedule 14 to the Wildlife and Countryside Act 1981 have been complied with. (Paragraph 2 is printed on the reverse of this form).

Details of Modification
ADDING THE FOOTPATH FROM BANKSIDE, HEBURN BRIDGE
TO ST JOHN'S CLOSE, HEBURN BRIDGE

List of Owners and Occupiers Notified:

PLOT NO.	OWNER / OCCUPIER	ADDRESS	DATE NOTICE SERVED
	[REDACTED]	1 Birch Villas, St. John's Close	1.9.10
	[REDACTED]	2 Birch Villas, St. John's Close	1.9.10
	[REDACTED]	1 St. John's Close	1.9.10
	[REDACTED]	2 St. John's Close	1.9.10
	[REDACTED]	3 St. John's Close	1.9.10
	[REDACTED]	4 St. John's Close	1.9.10
	[REDACTED]	4a St. John's Close	1.9.10
	[REDACTED]	4b St. John's Close	1.9.10
	[REDACTED]	5 St. John's Close	1.9.10
	[REDACTED]	6 St. John's Close	1.9.10

Signed [REDACTED] Date 1/9/10
(i) Insert name of applicant(s) (ii) Insert address of applicant(s)